



area calculations :

--- DENOTES SPACE LEASE LINE

TOTAL OVERALL LEASABLE SPACE SQUARE FOOTAGE = 814 S.F.

ceiling legend :

| | | | |
|---|---------------------------------------|---|----------------------------|
| ○ | SECURITY CAMERAS | ◻ | CEILING ACCESS PANEL |
| ○ | RECESSED LIGHT FIXTURES | ◻ | FLUORESCENT LIGHT FIXTURES |
| ⊗ | EXIT SIGNS | ◻ | CEILING TILE AND GRID |
| ⊕ | EXIT SIGN/EMERGENCY LIGHT COMBINATION | ◻ | DRYWALL CEILING |
| ⊕ | EMERGENCY LIGHT | ● | SPEAKER SYSTEM |
| ◻ | A/C SUPPLY GRILLES | ⊙ | MOTION DETECTOR |
| ◻ | A/C RETURN GRILLES | | |

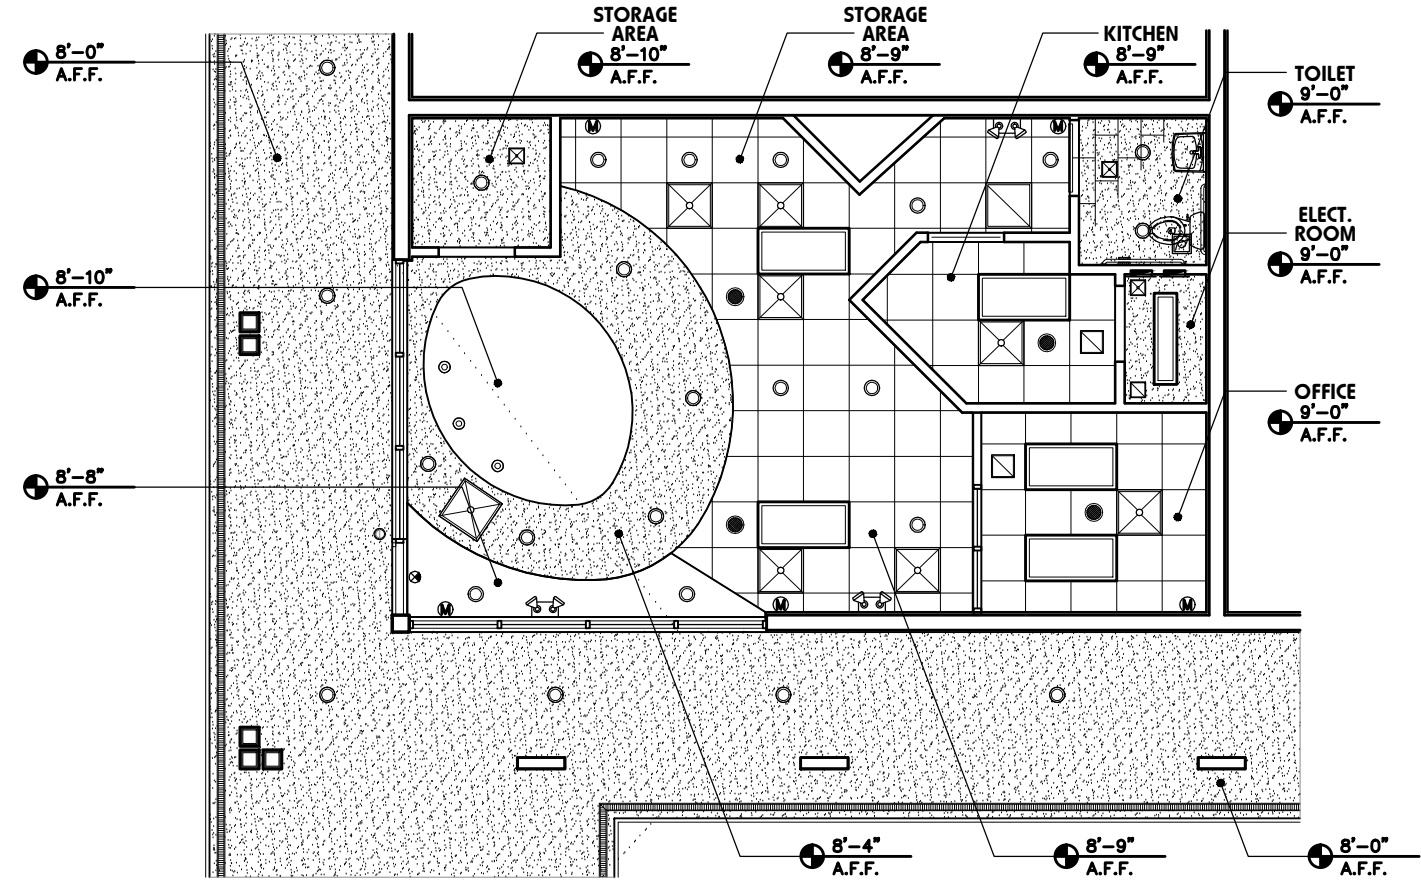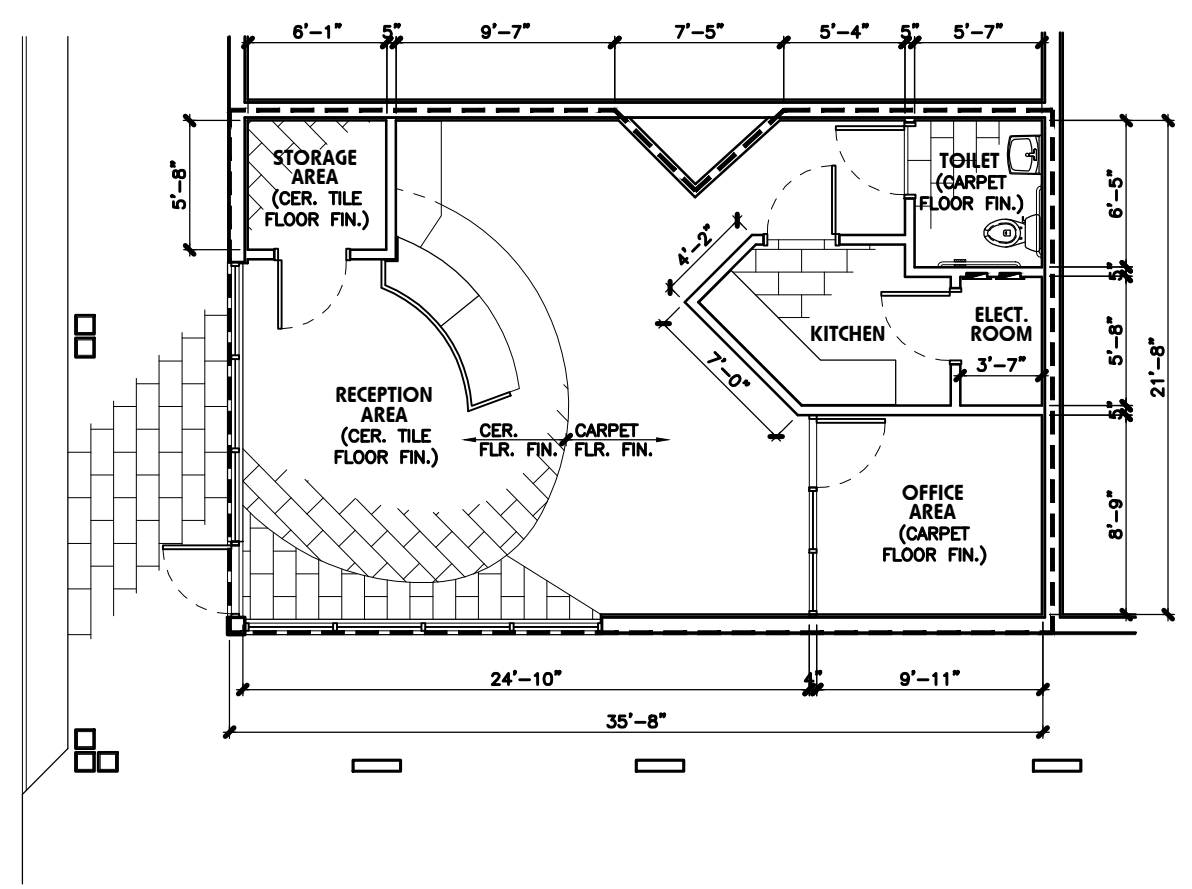

01 Existing Floor Plan
SCALE: 1/8" = 1'-0"

02 Existing Reflected Ceiling Plan
SCALE: 1/8" = 1'-0"


**Suniland Shopping Center
Interior As-Built (Vacant Space)**

11503 S. Dixie Highway
Pinecrest, Florida 33156

project no. : #16174
date : 10-25-2016
sheet number : **A-1**

MODIS Architects, LLC
4955 SW 75th Avenue
Miami, Florida 33155
t. 786.879.8882
f. 786.350.1515
w. www.modisarchitects.com



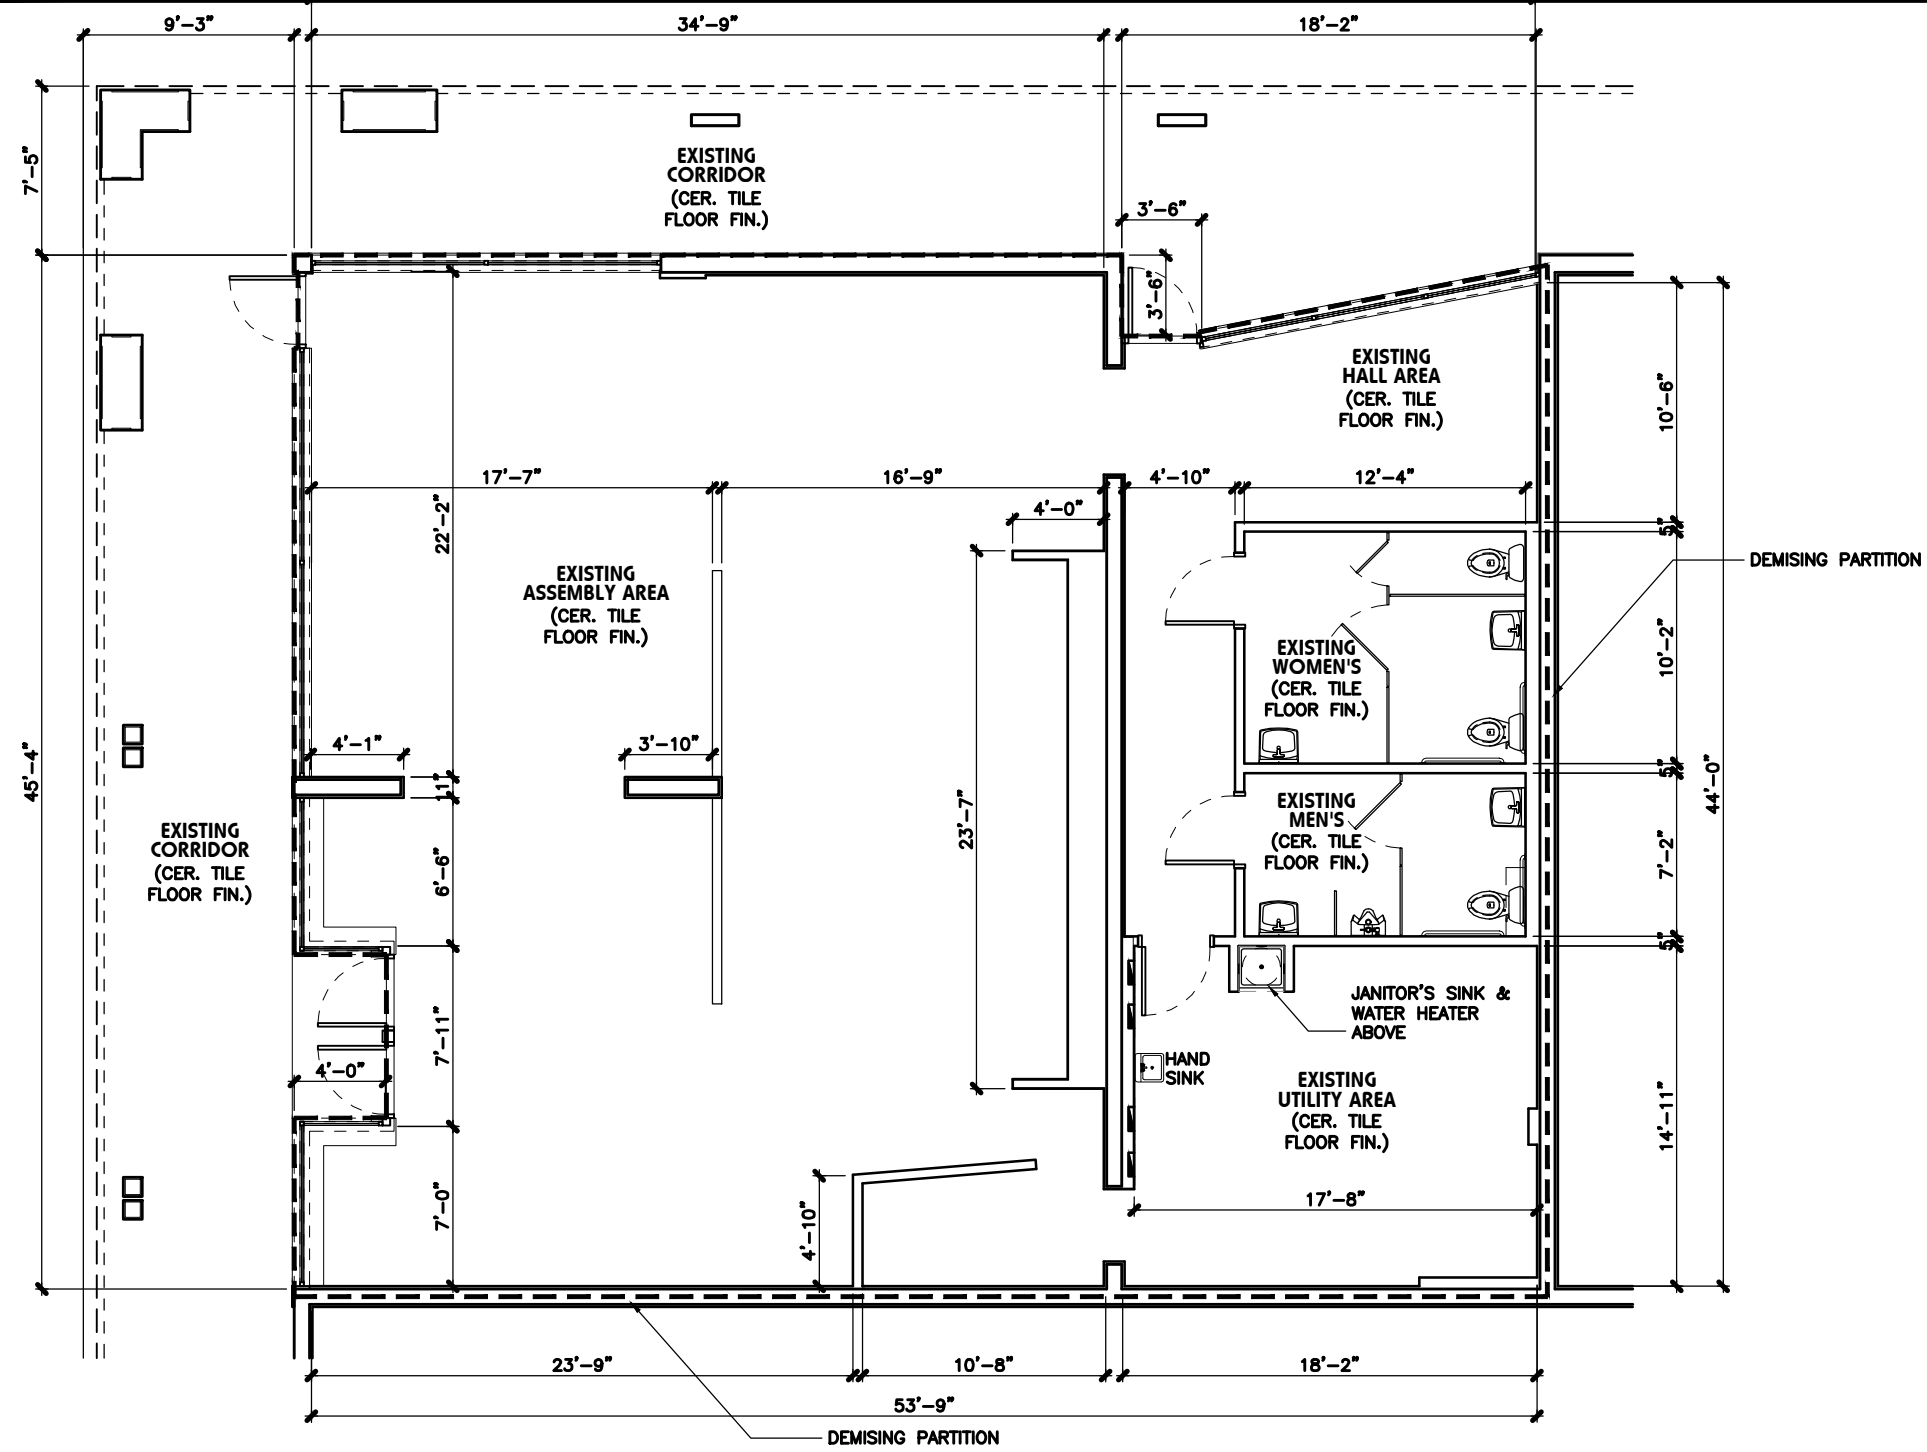

area calculations :

--- DENOTES SPACE LEASE LINE

TOTAL OVERALL LEASABLE SPACE SQUARE FOOTAGE = 2,438 S.F.

01 Existing Floor Plan
SCALE: 1/8"=1'-0"



**Suniland Shopping Center
Interior As-Built (Vacant Space)**

11515 S. Dixie Highway
Pinecrest, Florida 33156

project no. :
#16174

date :
11-04-2016

sheet number :
A-1

MODIS Architects, LLC
4955 SW 75th Avenue
Miami, Florida 33155
t. 786.879.8882
f. 786.350.1515
w. www.modisarchitects.com



copyright © MODIS Architects, LLC